



ALLOTMENT 308 in D 86777
 in the area named
BLAKEVIEW
 CT 6083/631
AS-CONSTRUCTED 20/08/2018

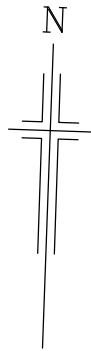

LIEBROOKE BOULEVARD

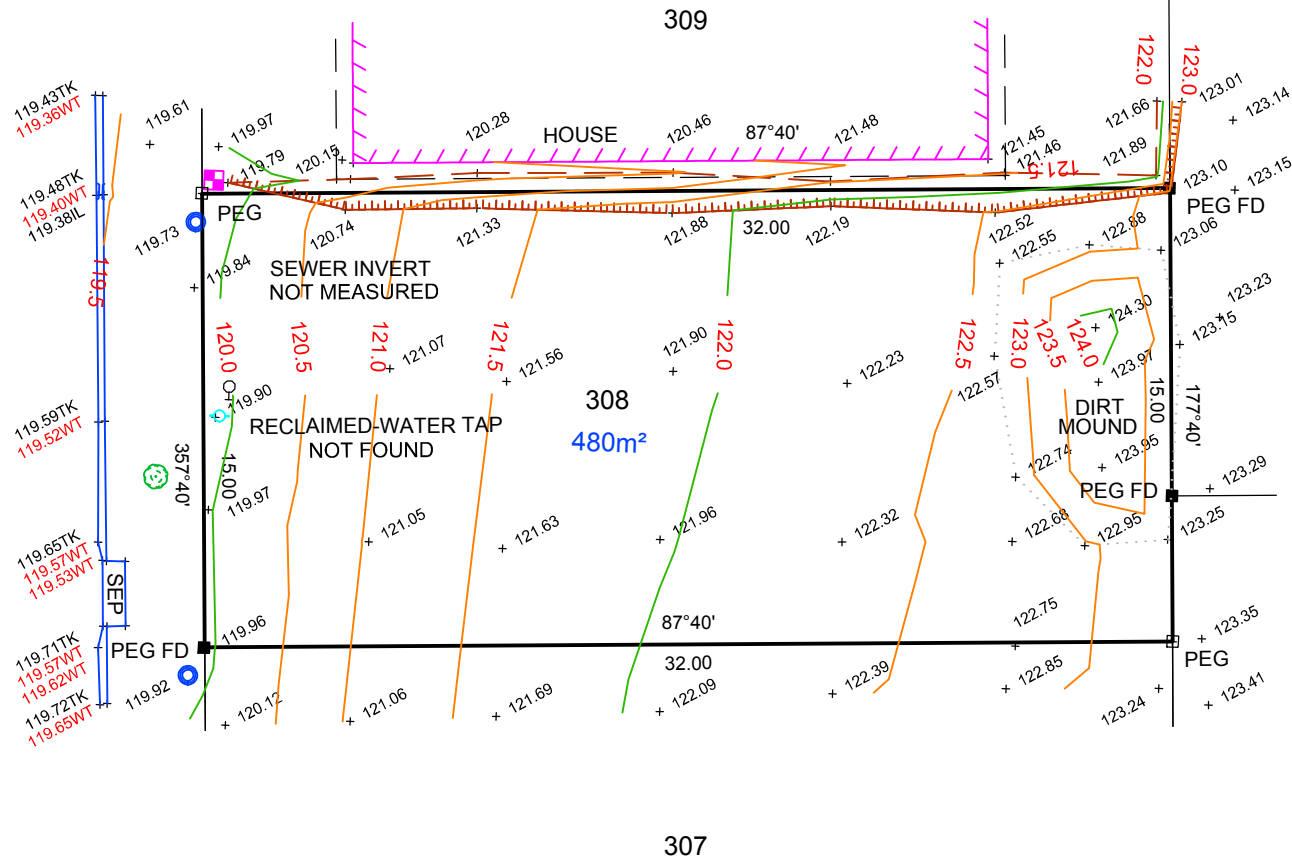


- LEGEND**
- WATER METER
 - SIP SEWER IP
 - STOBIE POLE
 - TELSTRA PIT
 - S/W GRATING
 - SEWER MAN HOLE
 - S/W MANHOLE
 - LIGHT POLE
 - ETSA CONNECTION
 - TAP
 - BOLLARD
 - SIGN
 - S/W CONNECTION
 - FOOTPATH
 - SIDE ENTRY PIT
 - COMMON SERVICE TRENCH
 - DOMESTIC
 - SEWER IO
 - NON-POTABLE WATER CONN
 - EXISTING TREE TO REMAIN




1:250

ALLOTMENT 312 in D 86777
in the area named
BLAKEVIEW
CT 6083/635
AS-CONSTRUCTED 20/08/2018

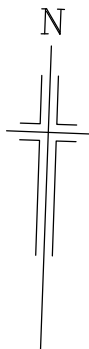

LIEBROOKE BOULEVARD

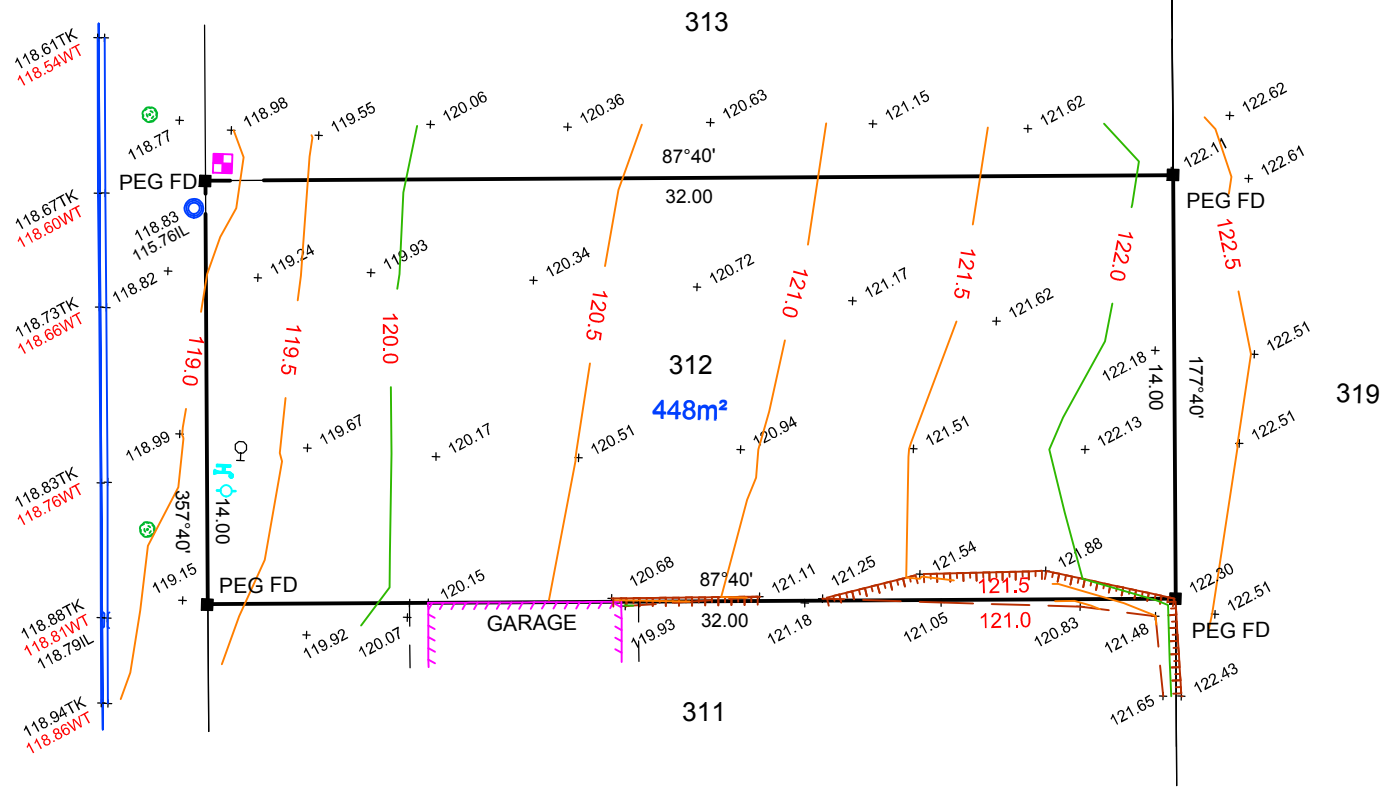

- LEGEND**
- WATER METER
 - SIP SEWER IP
 - STOBIE POLE
 - TELSTRA PIT
 - S/W GRATING
 - SEWER MAN HOLE
 - S/W MANHOLE
 - LIGHT POLE
 - ETSA CONNECTION
 - TAP
 - BOLLARD
 - SIGN
 - S/W CONNECTION
 - FOOTPATH
 - SIDE ENTRY PIT
 - COMMON SERVICE TRENCH
 - DOMESTIC
 - SEWER IO
 - NON-POTABLE WATER CONN
 - EXISTING TREE TO REMAIN



1:250