


**IMPORTANT**  
 DRIVEWAY LOCATIONS ARE APPROXIMATE  
 ANY CHANGES WILL BE AT THE PURCHASERS  
 EXPENSE.  
 PURCHASER: \_\_\_\_\_  
 PURCHASER: \_\_\_\_\_  
 DATE: \_\_\_\_\_

ALLOTMENT 341 in D 116981  
 in the area named  
**MUNNO PARA WEST**  
 C/T 6206/455

**AS CONSTRUCTED**

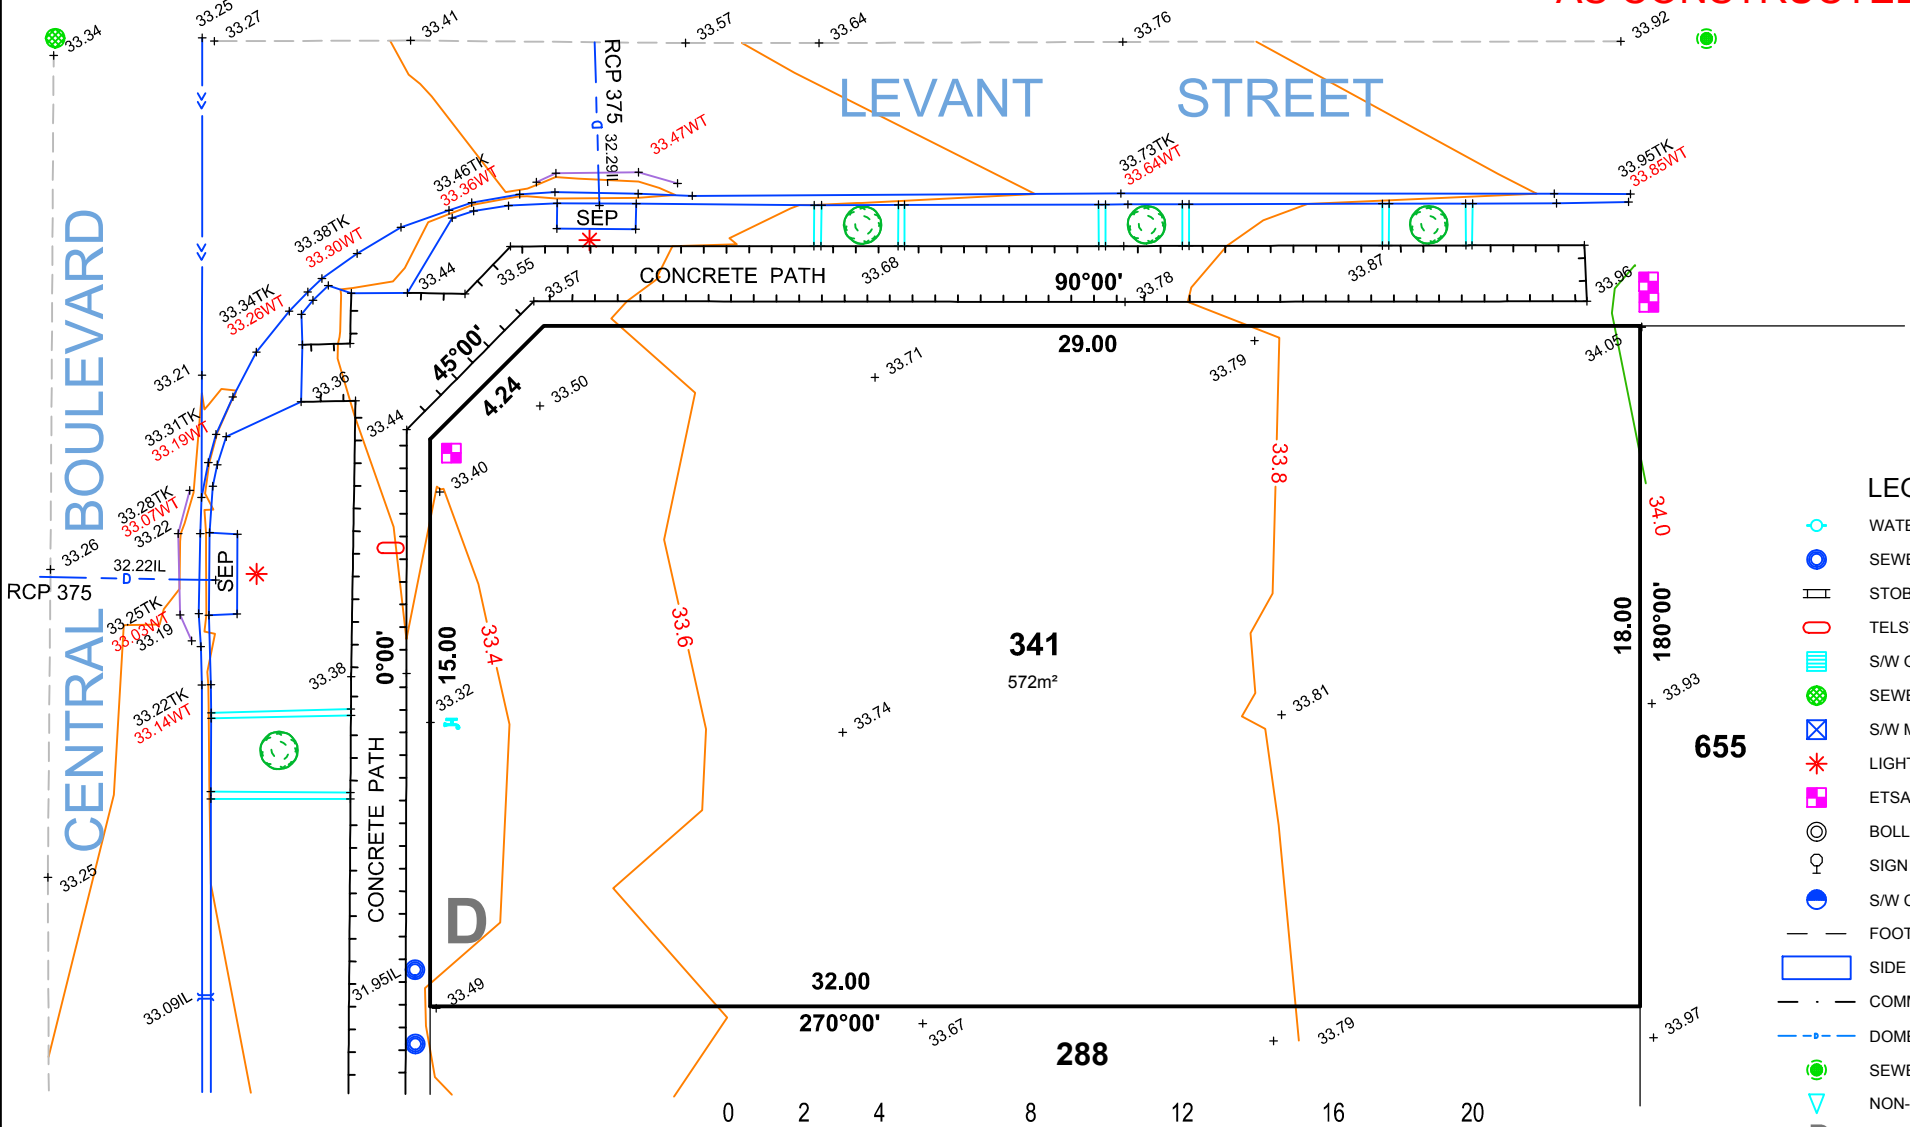

- LEGEND**
- WATER METER
  - SEWER IP
  - STOBIE POLE
  - TELSTRA PIT
  - S/W GRATING
  - SEWER MAN HOLE
  - S/W MANHOLE
  - LIGHT POLE
  - ETSA CONNECTION
  - BOLLARD
  - SIGN
  - S/W CONNECTION
  - FOOTPATH
  - SIDE ENTRY PIT
  - COMMON SERVICE TRENCH
  - DOMESTIC DRAIN
  - SEWER IO
  - NON-POTABLE WATER CONN
  - PROPOSED DRIVE WAY



1:200

ALEXANDER SYMONDS  
 PH 8130 1666  
 REF.: A118809.S006 ALMOND GROVE STAGE 6

ORIGINAL SHEET SIZE A4