



IMPORTANT
SERVICE AND DRIVEWAY LOCATIONS
HAVE BEEN SURVEYED. ANY CHANGES
WILL BE AT THE PURCHASERS EXPENSE.
PURCHASER: _____
PURCHASER: _____
DATE: _____

ALLOTMENT 2317 in DEV. NO. 145/D142/13/005
in the area named
SEAFORD MEADOWS
CT ---/----

AS CONSTRUCTED

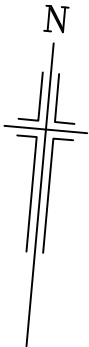

SEASIDE STREET

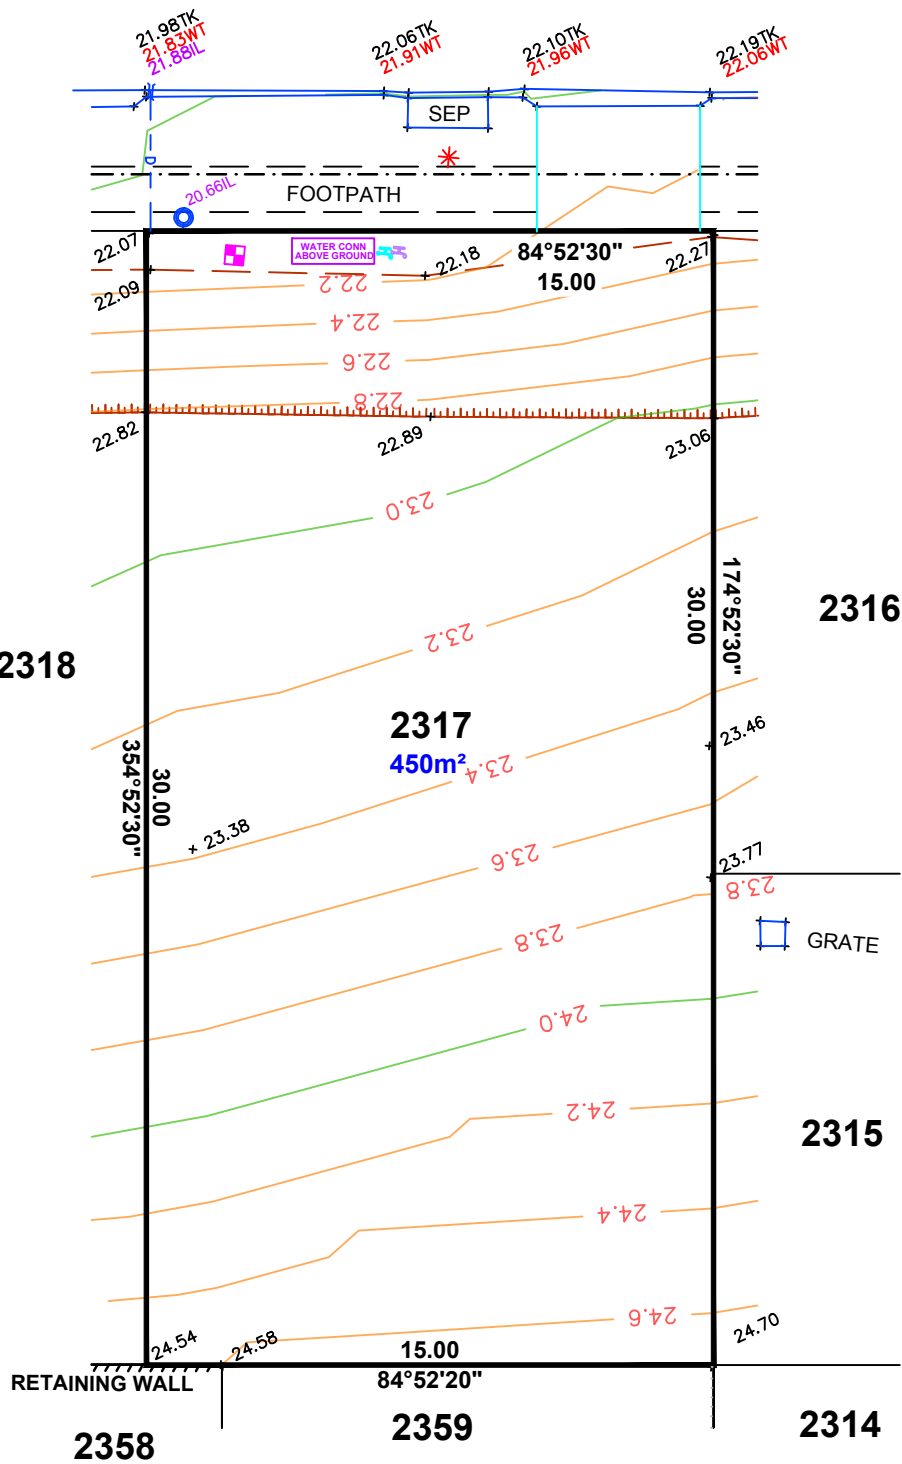


- LEGEND
- WATER METER
 - SEWER IP
 - STOBIE POLE
 - TELSTRA PIT
 - S/W GRATING
 - SEWER MAN HOLE
 - S/W MANHOLE
 - LIGHT POLE
 - ETSA CONNECTION
 - TAP
 - BOLLARD
 - SIGN
 - S/W CONNECTION
 - FOOTPATH
 - SIDE ENTRY PIT
 - COMMON SERVICE TRENCH
 - DOMESTIC
 - SEWER IO
 - NON-POTABLE WATER CONN
 - NON-POTABLE WATER CONN
 - 29.00TRW
 - TOP RETAINING WALL

NOTE:
DRIVEWAY IN PAVERS
BY DEVELOPER

NOTE: FOOTPATH & CST DATA SHOWN HEREON IS DESIGN INFORMATION
AND SHOULD BE CONFIRMED.


ALEXANDER SYMONDS
PH 8130 1666

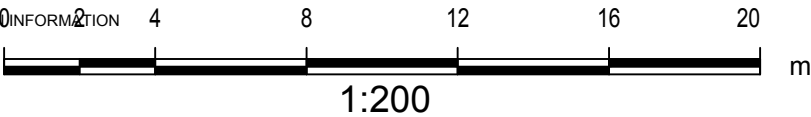


IMPORTANT
SERVICE AND DRIVEWAY LOCATIONS
HAVE BEEN SURVEYED. ANY CHANGES
WILL BE AT THE PURCHASERS EXPENSE.
PURCHASER: _____
PURCHASER: _____
DATE: _____

ALLOTMENT 2318 in DEV. NO. 145/D142/13/005
in the area named
SEAFORD MEADOWS
CT ---/----

AS CONSTRUCTED

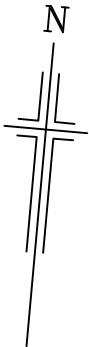

SEASIDE STREET

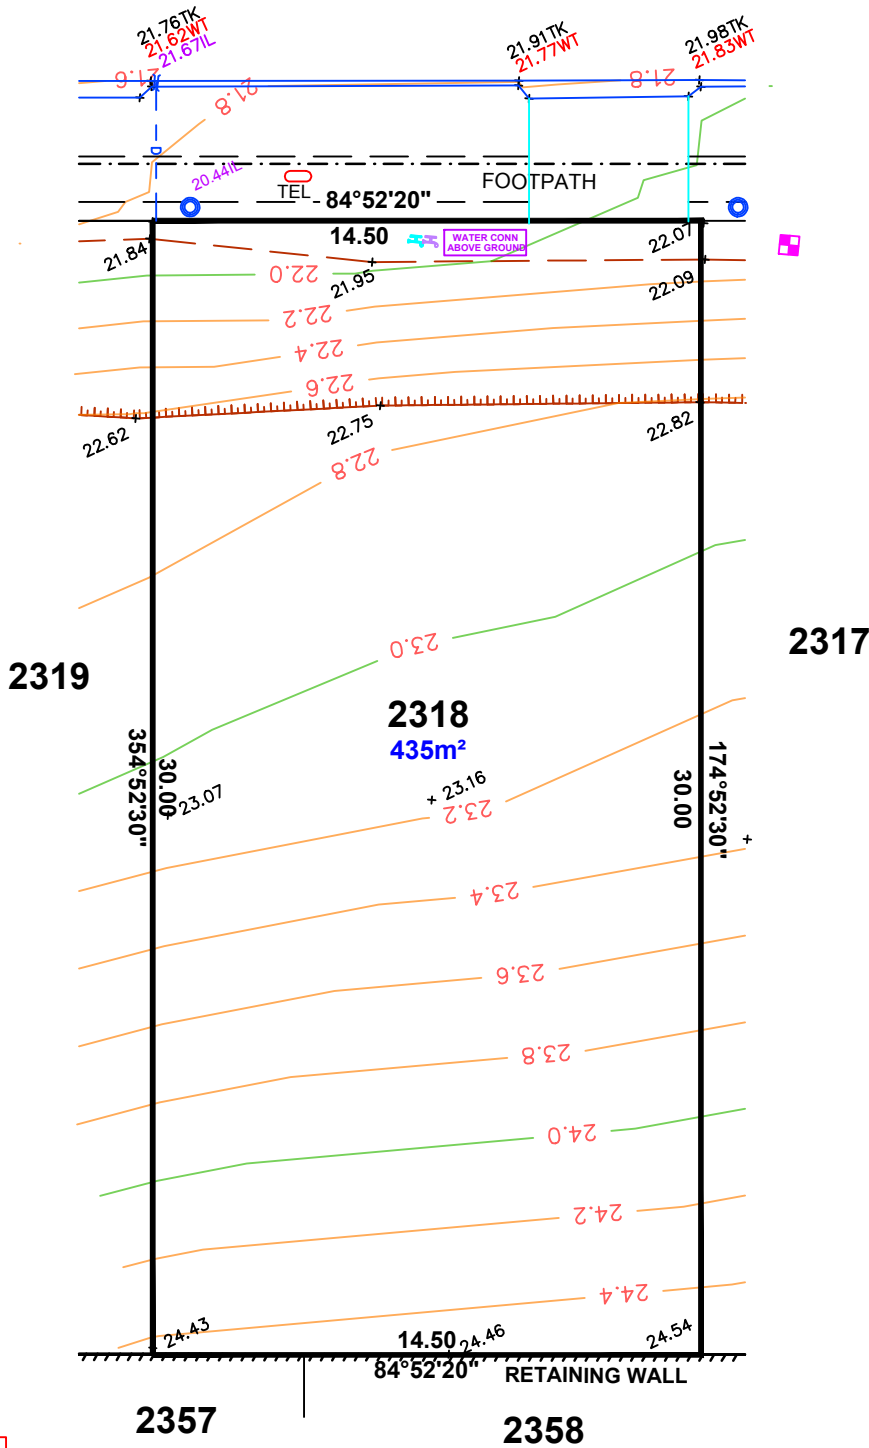

- LEGEND
- WATER METER
 - SEWER IP
 - STOBIE POLE
 - TELSTRA PIT
 - S/W GRATING
 - SEWER MAN HOLE
 - S/W MANHOLE
 - * LIGHT POLE
 - ETSA CONNECTION
 - TAP
 - ⊙ BOLLARD
 - ♀ SIGN
 - S/W CONNECTION
 - FOOTPATH
 - SIDE ENTRY PIT
 - . - COMMON SERVICE TRENCH
 - - - DOMESTIC
 - SEWER IO
 - HT NON-POTABLE WATER CONN
 - HT NON-POTABLE WATER CONN
 - 29.00TRW TOP RETAINING WALL

NOTE:
DRIVEWAY IN PAVERS
BY DEVELOPER

NOTE: FOOTPATH & CST DATA SHOWN HEREON IS DESIGN INFORMATION
AND SHOULD BE CONFIRMED.


ALEXANDER SYMONDS
PH 8130 1666




IMPORTANT
SERVICE AND DRIVEWAY LOCATIONS
HAVE BEEN SURVEYED. ANY CHANGES
WILL BE AT THE PURCHASERS EXPENSE.
PURCHASER: _____
PURCHASER: _____
DATE: _____

ALLOTMENT 2319 in DEV. NO. 145/D142/13/005
in the area named
SEAFORD MEADOWS
CT ---/----

AS CONSTRUCTED

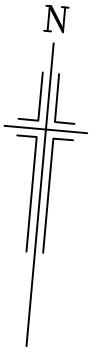

SEASIDE STREET

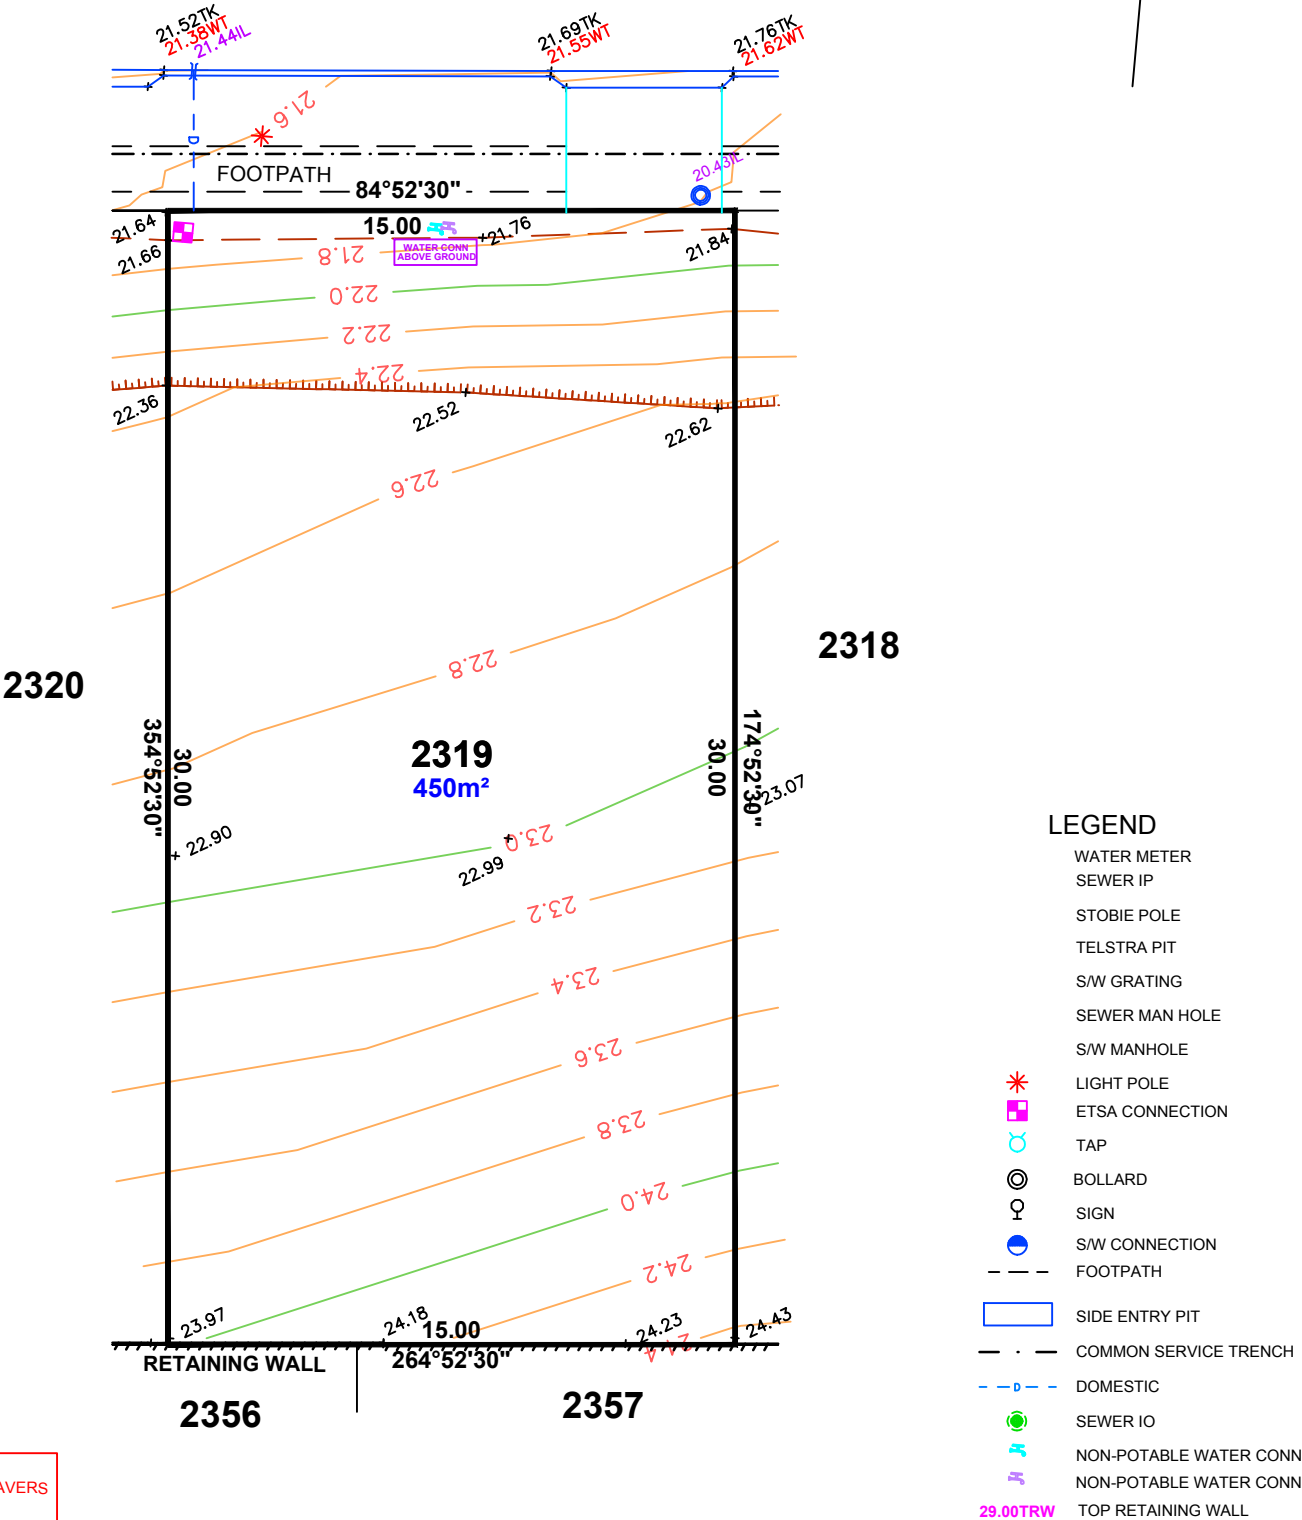

NOTE:
DRIVEWAY IN PAVERS
BY DEVELOPER

NOTE: FOOTPATH & CST DATA SHOWN HEREON IS DESIGN INFORMATION
AND SHOULD BE CONFIRMED.


ALEXANDER SYMONDS
PH 8130 1666

1:200


IMPORTANT
SERVICE AND DRIVEWAY LOCATIONS
HAVE BEEN SURVEYED. ANY CHANGES
WILL BE AT THE PURCHASERS EXPENSE.
PURCHASER: _____
PURCHASER: _____
DATE: _____

ALLOTMENT 2320 in DEV. NO. 145/D142/13/005
in the area named
SEAFORD MEADOWS
CT ---/----

AS CONSTRUCTED

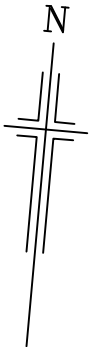

SEASIDE STREET

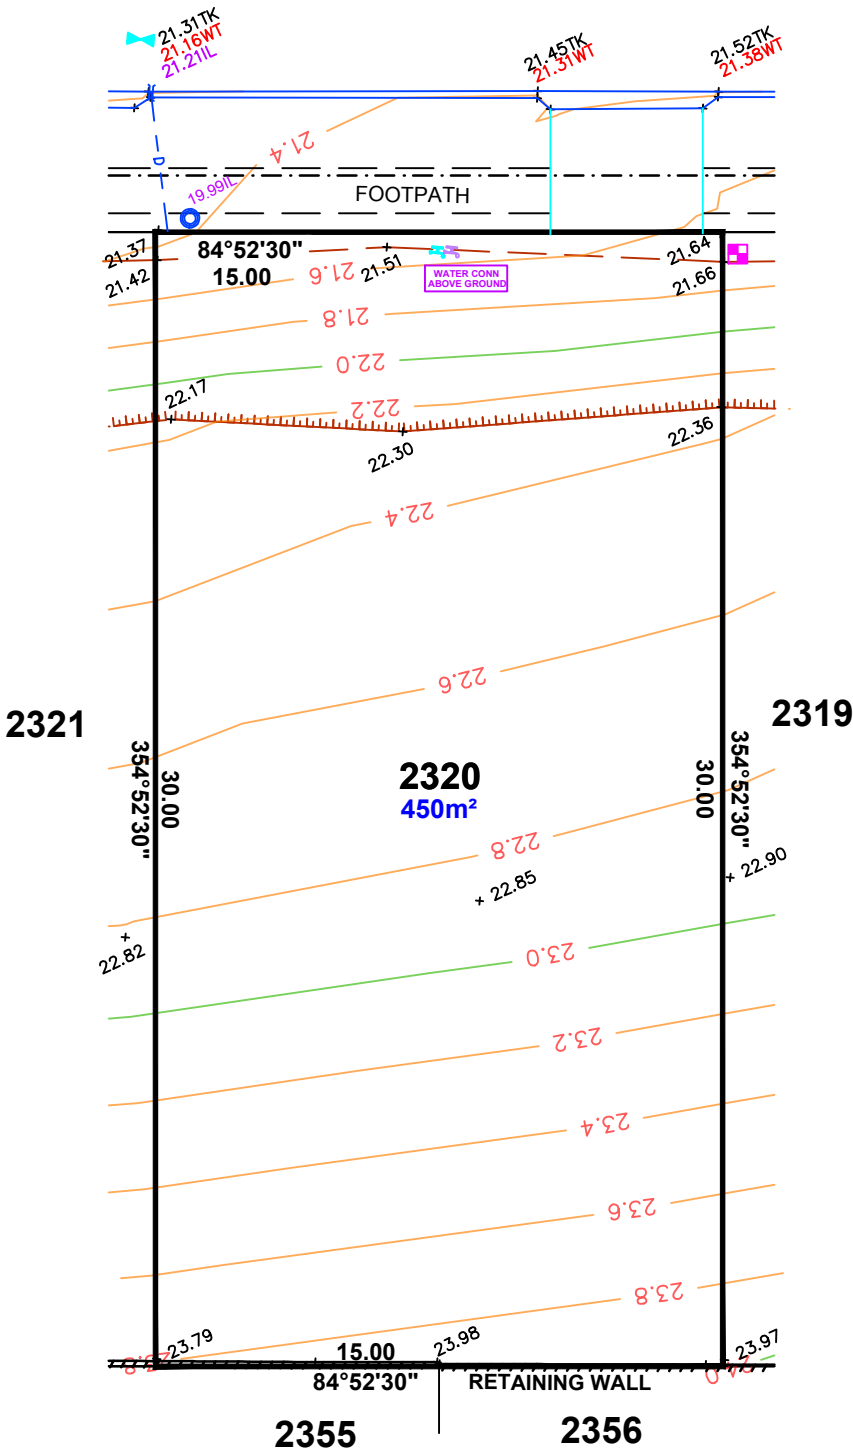

- LEGEND
- WATER METER
 - SEWER IP
 - STOBIE POLE
 - TELSTRA PIT
 - S/W GRATING
 - SEWER MAN HOLE
 - S/W MANHOLE
 - LIGHT POLE
 - ETSA CONNECTION
 - TAP
 - BOLLARD
 - SIGN
 - S/W CONNECTION
 - FOOTPATH
 - SIDE ENTRY PIT
 - COMMON SERVICE TRENCH
 - DOMESTIC
 - SEWER IO
 - NON-POTABLE WATER CONN
 - NON-POTABLE WATER CONN
 - TOP RETAINING WALL

NOTE:
DRIVEWAY IN PAVERS
BY DEVELOPER

NOTE: FOOTPATH & CST DATA SHOWN HEREON IS DESIGN INFORMATION
AND SHOULD BE CONFIRMED.



ALEXANDER SYMONDS
PH 8130 1666

1:200

PURCHASER: _____
PURCHASER: _____
DATE: _____

CT ---/----

Property Details:

- Lot Number:** 2321
- Area:** 450m²
- Boundaries:**
 - North: 84°52'30"
 - East: 174°52'30"
 - South: 264°52'30"
 - West: 354°52'30"

Infrastructure and Features:

- Footpath:** Located to the north of the lot.
- Retaining Wall:** Located to the south of the lot.
- Water Connection:** Labeled "WATER CONN. ABOVE GROUND" near the north boundary.
- Elevation Contours:**
 - Orange lines: 21.2, 21.4, 21.6, 21.8, 22.2, 22.4, 22.6, 22.8, 23.2, 23.4, 23.6
 - Green line: 22.0
 - Red line: 23.8

Boundary Measurements:

- North Boundary: 15.00
- East Boundary: 30.00
- South Boundary: 15.00
- West Boundary: 30.00

Other Labels:

- 21.09TK, 21.00WT, 21.00IL
- 21.25TK, 21.09WT
- 21.31TK, 21.16WT
- 19.99IL
- 21.21, 21.20, 22.11, 22.15, 22.82, 23.64, 23.66, 23.79, 23.84
- 2364, 2355

	WATER METER
	SEWER IP
	STOBIE POLE
	TELSTRA PIT
	S/W GRATING
	SEWER MAN HOLE
	S/W MANHOLE
	LIGHT POLE
	ETSA CONNECTION
	TAP
	BOLLARD
	SIGN
	S/W CONNECTION
— — —	FOOTPATH
	SIDE ENTRY PIT
— . —	COMMON SERVICE TRENCH
— D —	DOMESTIC
	SEWER IO
	NON-POTABLE WATER CONN
	NON-POTABLE WATER CONN
0.00TRW	TOP RETAINING WALL

NOTE:
DRIVEWAY IN PAVERS
BY DEVELOPER

NOTE: FOOTPATH & CST DATA SHOWN HEREON IS DESIGN INFORMATION
AND SHOULD BE CONFIRMED.

ALEXANDER SYMONDS
PH 8130 1666

0 INFORMATION 4 8 12 16 20 m

1:200

CT ---/---


DATE: _____

1:200


IMPORTANT
SERVICE AND DRIVEWAY LOCATIONS
ARE SURVEYED. ANY CHANGES WILL
BE AT THE PURCHASERS EXPENSE.
PURCHASER: _____
PURCHASER: _____
DATE: _____

ALLOTMENT 2362 in DEV. NO. 145/D142/13/004
in the area named
SEAFORD MEADOWS
CT ---/----

AS CONSTRUCTED

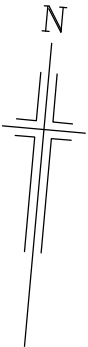

MAGELLAN ROAD

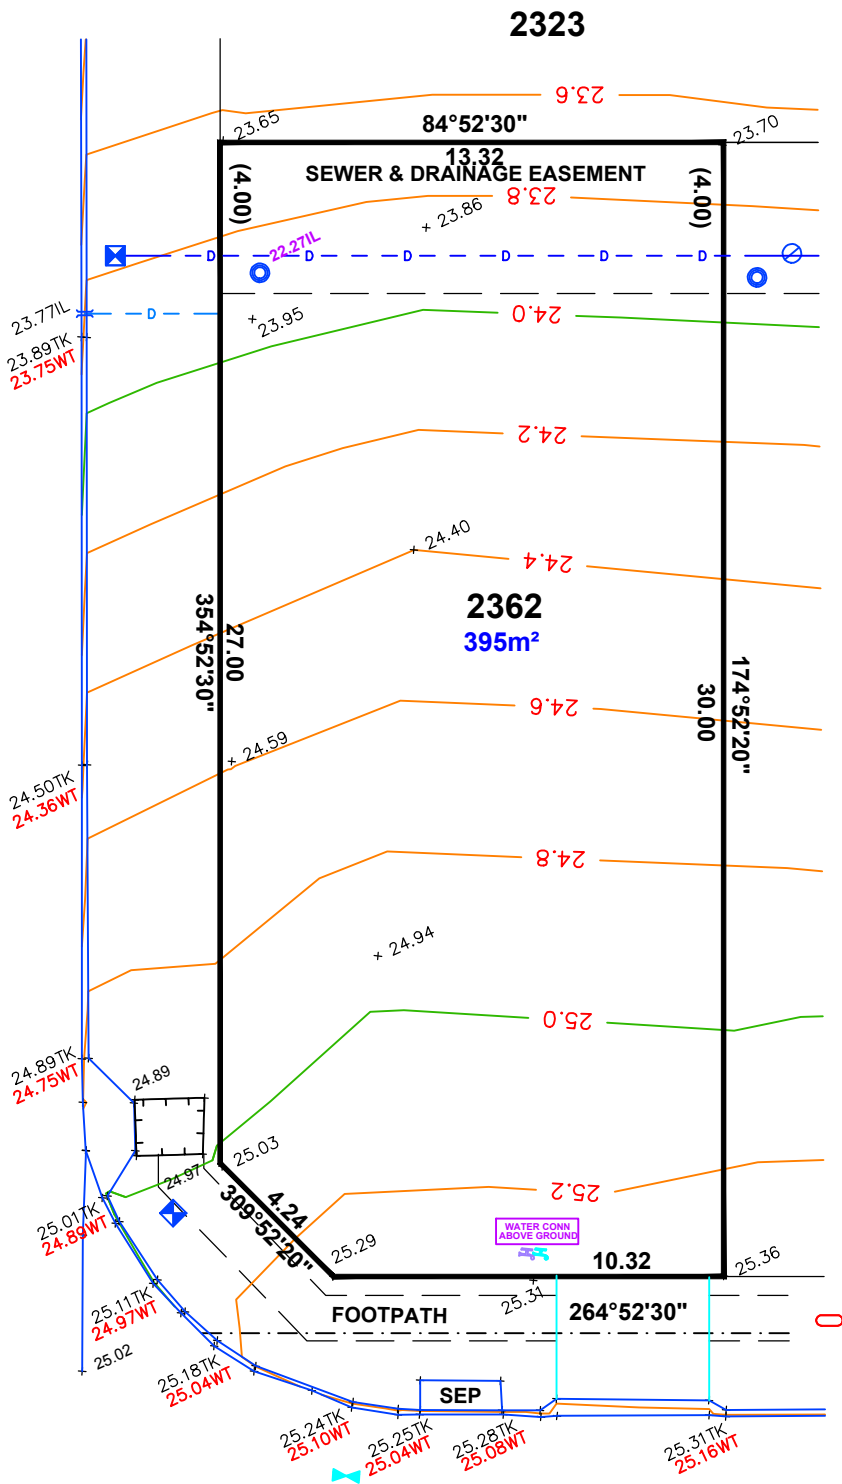


2363

- LEGEND**
- WATER METER
 - SEWER IP
 - STOBIE POLE
 - TELSTRA PIT
 - S/W GRATING
 - SEWER MAN HOLE
 - S/W MANHOLE
 - LIGHT POLE
 - ETSA CONNECTION
 - TAP
 - BOLLARD
 - SIGN
 - S/W CONNECTION
 - FOOTPATH
 - SIDE ENTRY PIT
 - COMMON SERVICE TRENCH
 - DOMESTIC
 - SEWER IO
 - NON-POTABLE WATER CONN
 - NON-POTABLE WATER CONN
 - TOP RETAINING WALL

NOTE:
DRIVEWAY IN PAVERS
BY DEVELOPER

NOTE: DATA SHOWN HEREON IS DESIGN INFORMATION
AND SHOULD BE CONFIRMED.

ALEXANDER SYMONDS
PH 8130 1666

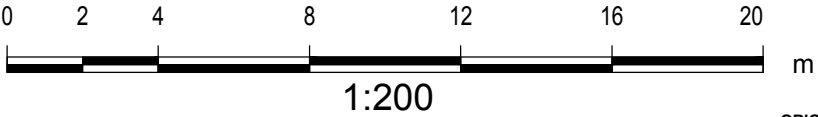


ORIGINAL SHEET SIZE A4


IMPORTANT
SERVICE AND DRIVEWAY LOCATIONS
ARE SURVEYED. ANY CHANGES WILL
BE AT THE PURCHASERS EXPENSE.
PURCHASER: _____
PURCHASER: _____
DATE: _____

ALLOTMENT 2322 in DEV. NO. 145/D142/13/004
in the area named
SEAFORD MEADOWS
CT ---/----

AS CONSTRUCTED

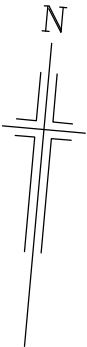


SEASIDE STREET

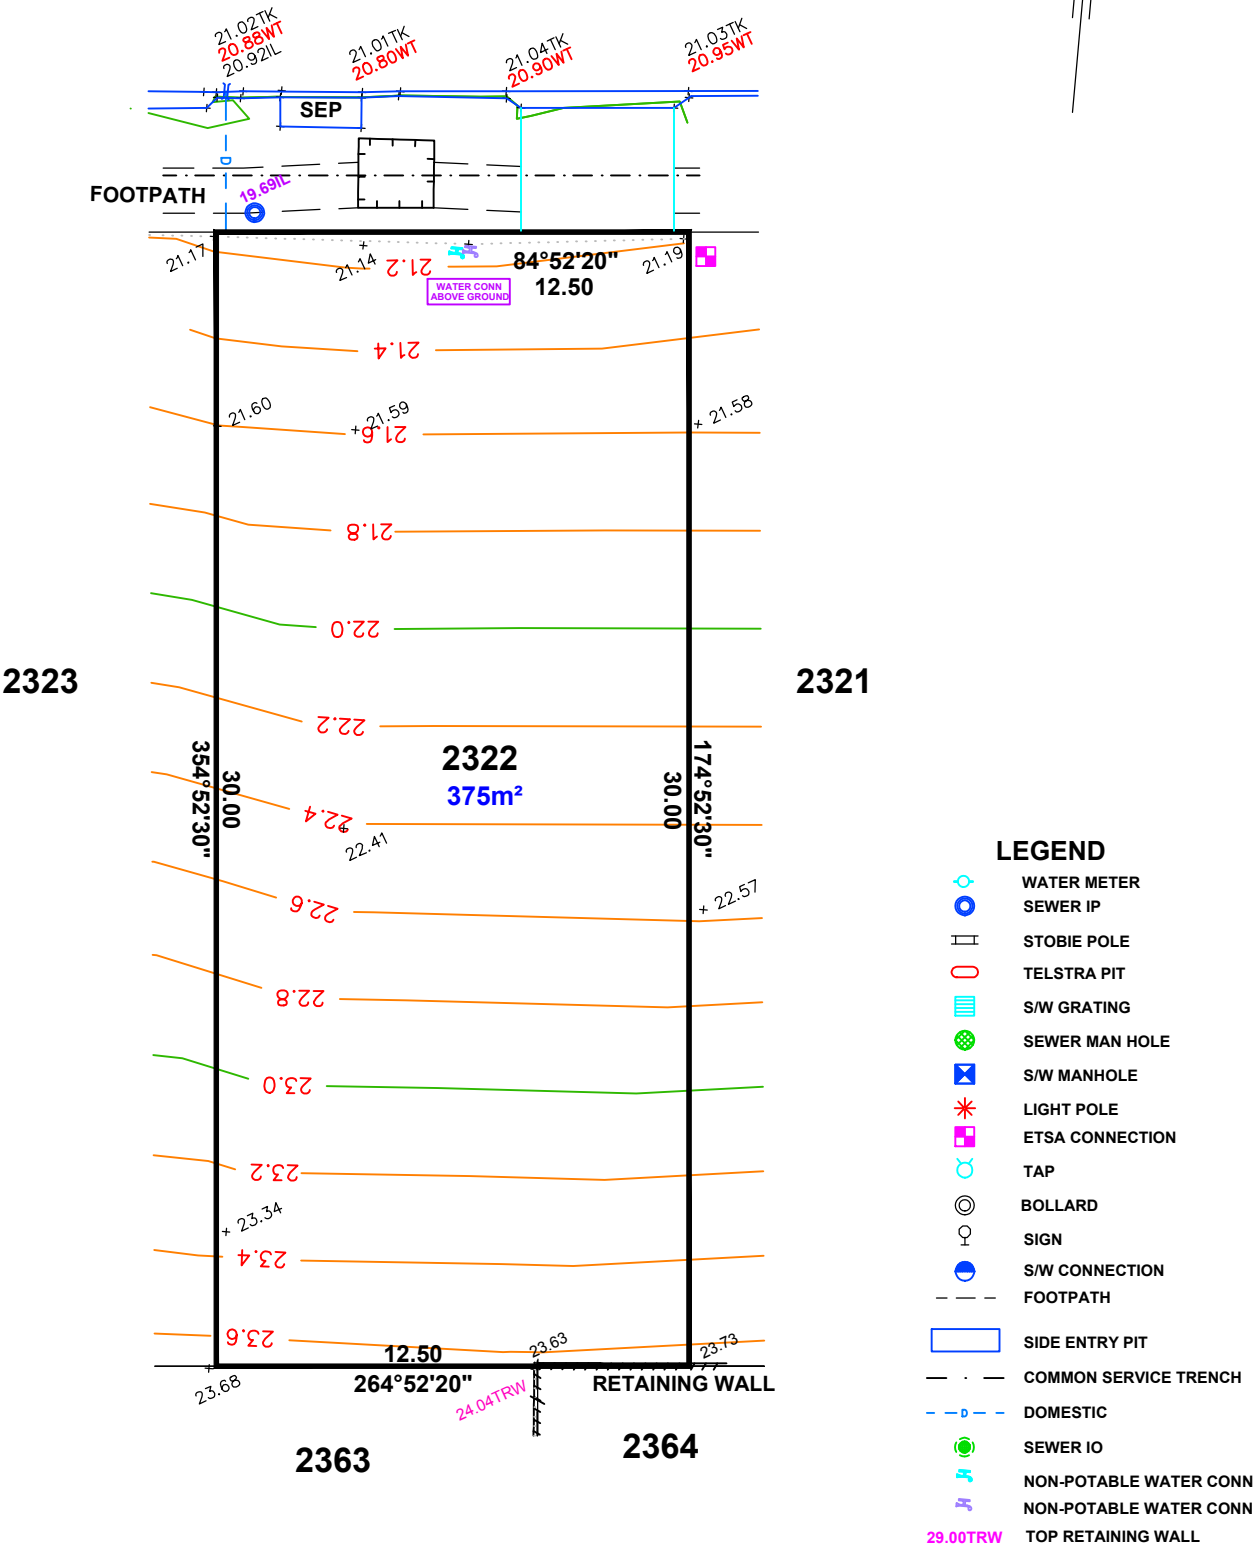

NOTE:
DRIVEWAY IN PAVERS
BY DEVELOPER

NOTE: DATA SHOWN HEREON IS DESIGN INFORMATION
AND SHOULD BE CONFIRMED.

ALEXANDER SYMONDS
PH 8130 1666

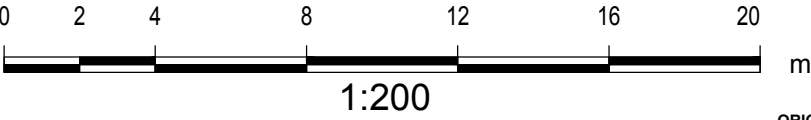

ORIGINAL SHEET SIZE A4


ALLOTMENT 2323 in DEV. NO. 145/D142/13/004

in the area named

SEAFORD MEADOWS


CT ---/----

AS CONSTRUCTED

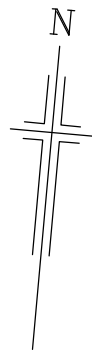

SEASIDE STREET

MAGELLAN ROAD

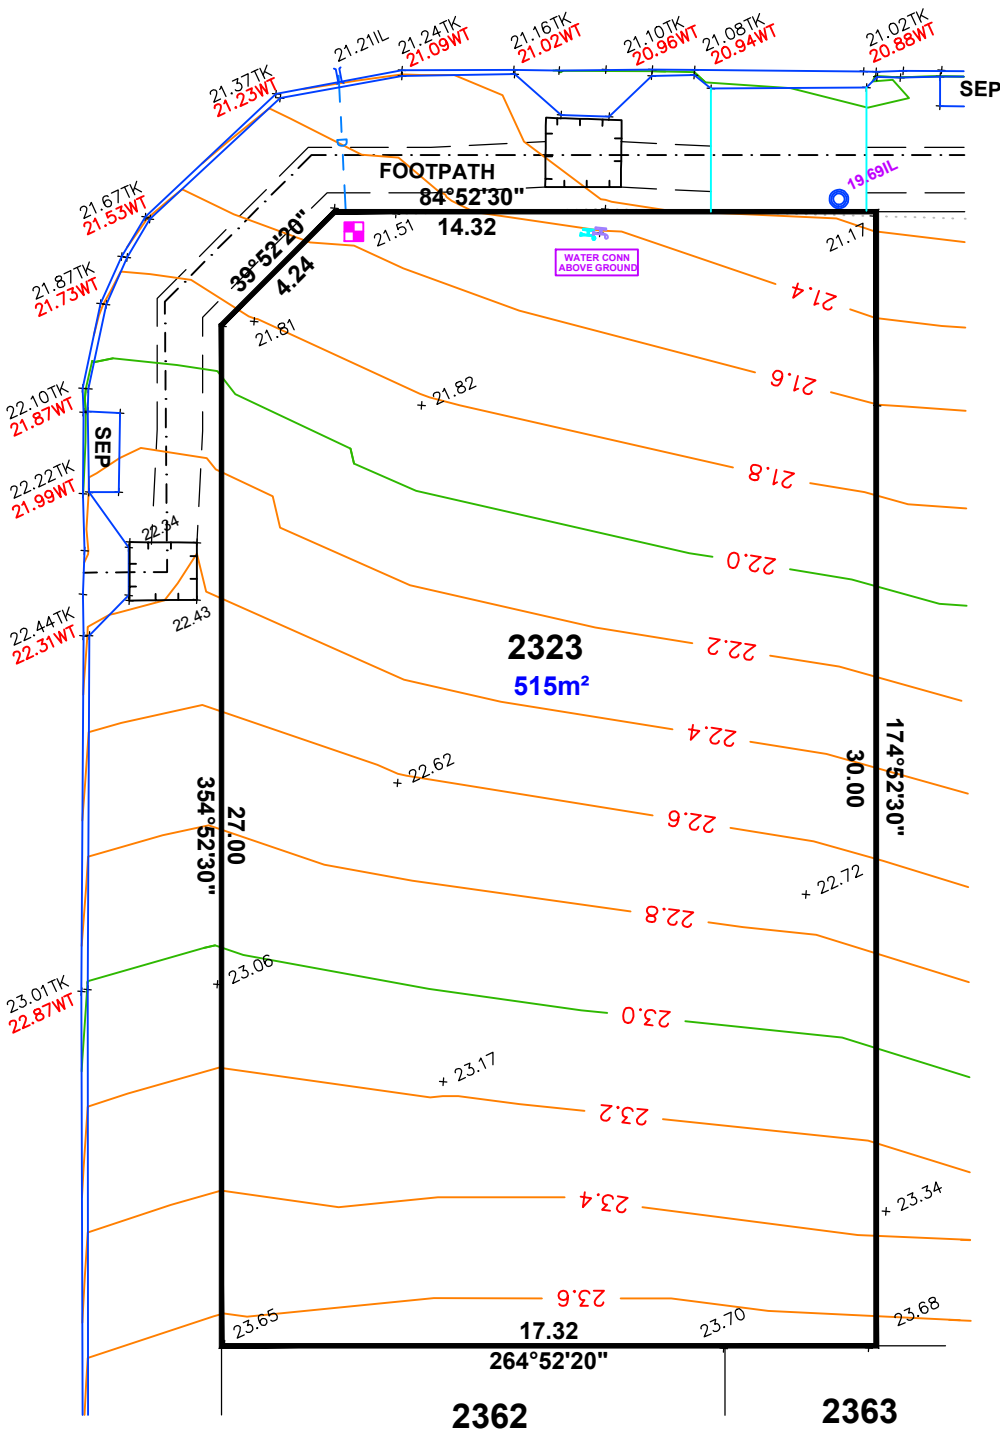

2322

2323
515m²

2362

2363


LEGEND

- WATER METER
- SEWER IP
- STOBIE POLE
- TELSTRA PIT
- S/W GRATING
- SEWER MAN HOLE
- S/W MANHOLE
- LIGHT POLE
- ETSA CONNECTION
- TAP
- BOLLARD
- SIGN
- S/W CONNECTION
- FOOTPATH
- SIDE ENTRY PIT
- COMMON SERVICE TRENCH
- DOMESTIC
- SEWER IO
- NON-POTABLE WATER CONN
- NON-POTABLE WATER CONN
- TOP RETAINING WALL

NOTE:
DRIVEWAY IN PAVERS
BY DEVELOPER

NOTE: DATA SHOWN HEREON IS DESIGN INFORMATION
AND SHOULD BE CONFIRMED.

ALEXANDER SYMONDS
PH 8130 1666


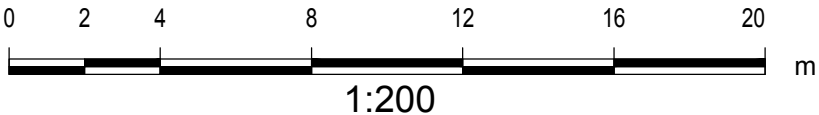


ORIGINAL SHEET SIZE A4

IMPORTANT
 SERVICE AND DRIVEWAY LOCATIONS
 ARE SURVEYED. ANY CHANGES WILL
 BE AT THE PURCHASERS EXPENSE.
 PURCHASER: _____
 PURCHASER: _____
 DATE: _____

ALLOTMENT 2363 in DEV. NO. 145/D142/13/004
 in the area named
SEAFORD MEADOWS
 CT ---/----

AS CONSTRUCTED

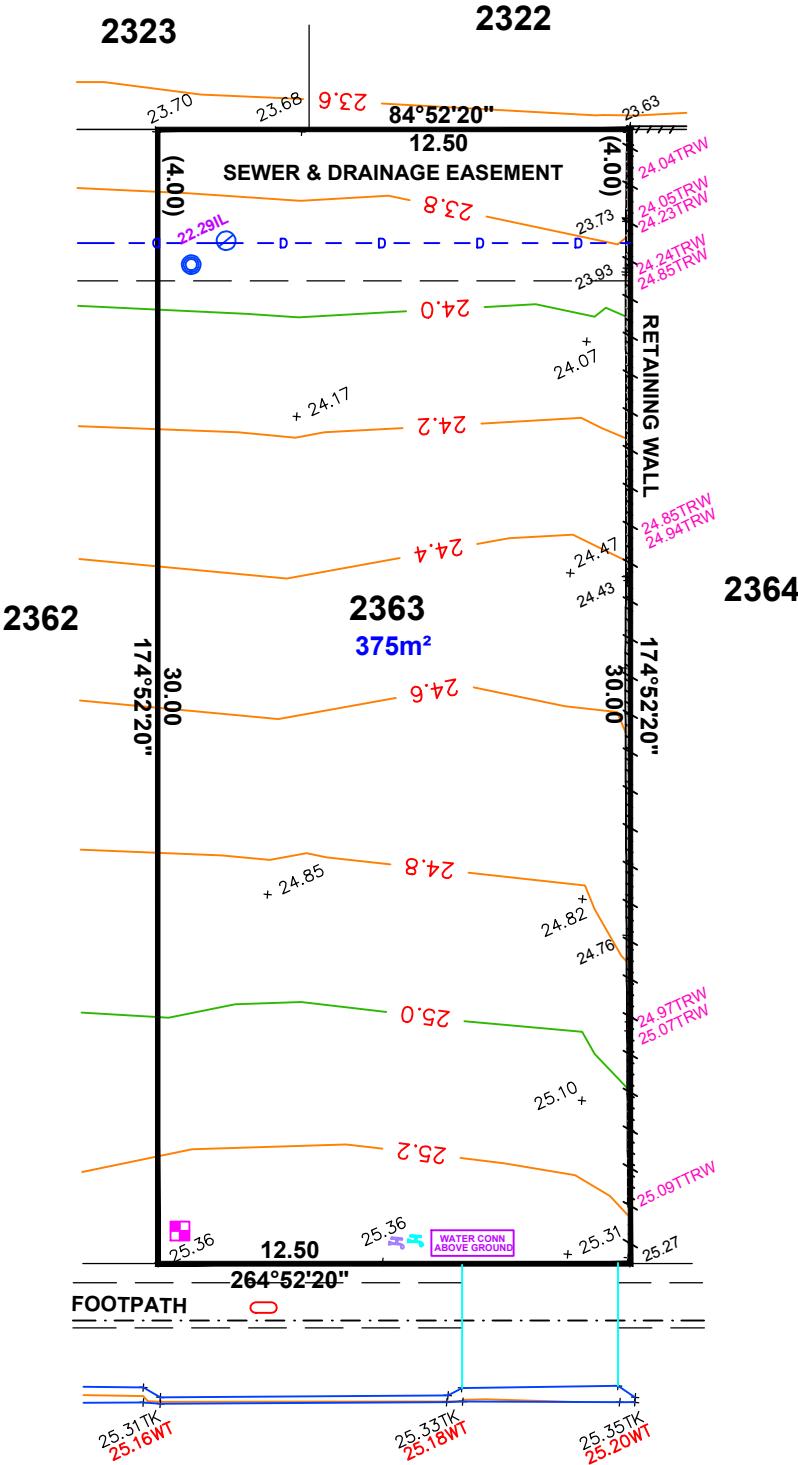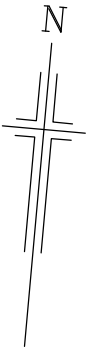


LEGEND

- WATER METER
- SEWER IP
- STOBIE POLE
- TELSTRA PIT
- S/W GRATING
- SEWER MAN HOLE
- S/W MANHOLE
- LIGHT POLE
- ETSA CONNECTION
- TAP
- BOLLARD
- SIGN
- S/W CONNECTION
- FOOTPATH
- SIDE ENTRY PIT
- COMMON SERVICE TRENCH
- DOMESTIC
- SEWER IO
- NON-POTABLE WATER CONN
- NON-POTABLE WATER CONN
- TOP RETAINING WALL

NOTE:
 DRIVEWAY IN PAVERS
 BY DEVELOPER

NOTE: DATA SHOWN HEREON IS DESIGN INFORMATION
 AND SHOULD BE CONFIRMED.

ALEXANDER SYMONDS
 PH 8130 1666


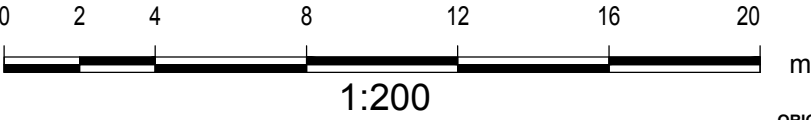


ORIGINAL SHEET SIZE A4

**ALLOTMENT 2377 in DEV. NO. 145/D142/13/004
in the area named
SEAFORD MEADOWS**

CT ---

AS CONSTRUCTED

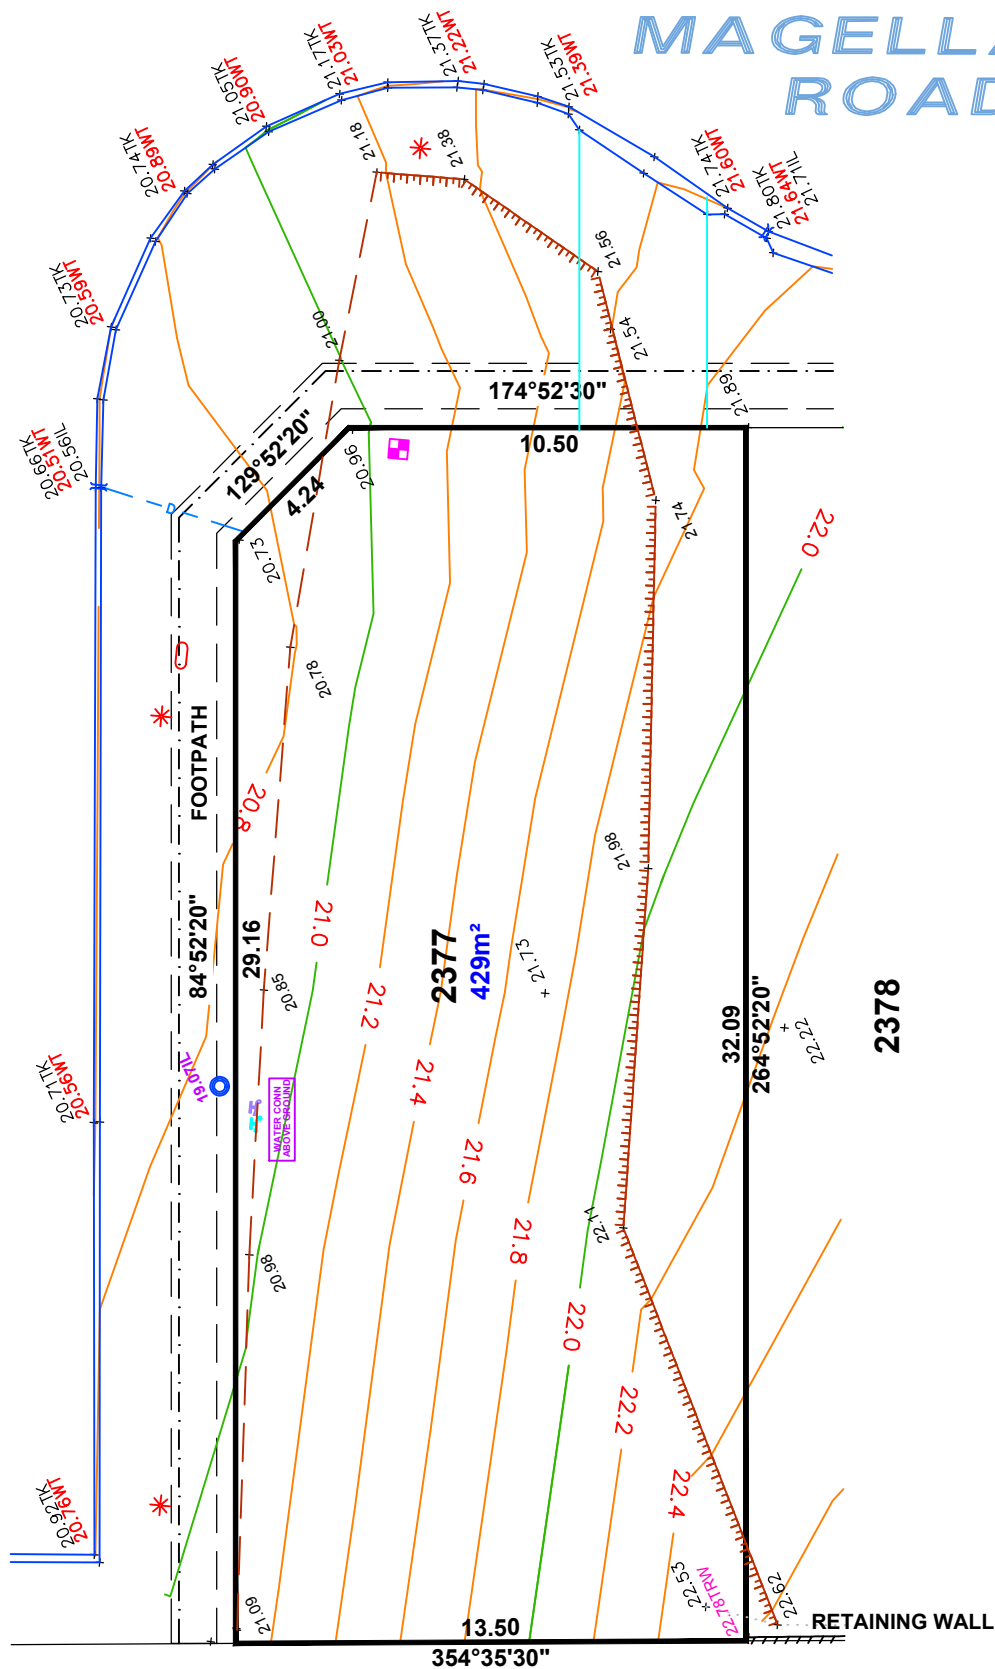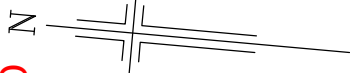

NOTE:
DRIVEWAY IN PAVERS
BY DEVELOPER





DISCLAIMER: FOOTPATH & CST DATA SHOWN HEREON IS DESIGN INFORMATION AND SHOULD BE CONFIRMED

ORIGINAL SHEET SIZE A4


IMPORTANT
SERVICE AND DRIVEWAY LOCATIONS
ARE SURVEYED. ANY CHANGES WILL
BE AT THE PURCHASERS EXPENSE.
PURCHASER: _____
PURCHASER: _____
DATE: _____

ALLOTMENT 2378 in DEV. NO. 145/D142/13/004
in the area named
SEAFORD MEADOWS
CT ---/---
AS CONSTRUCTED

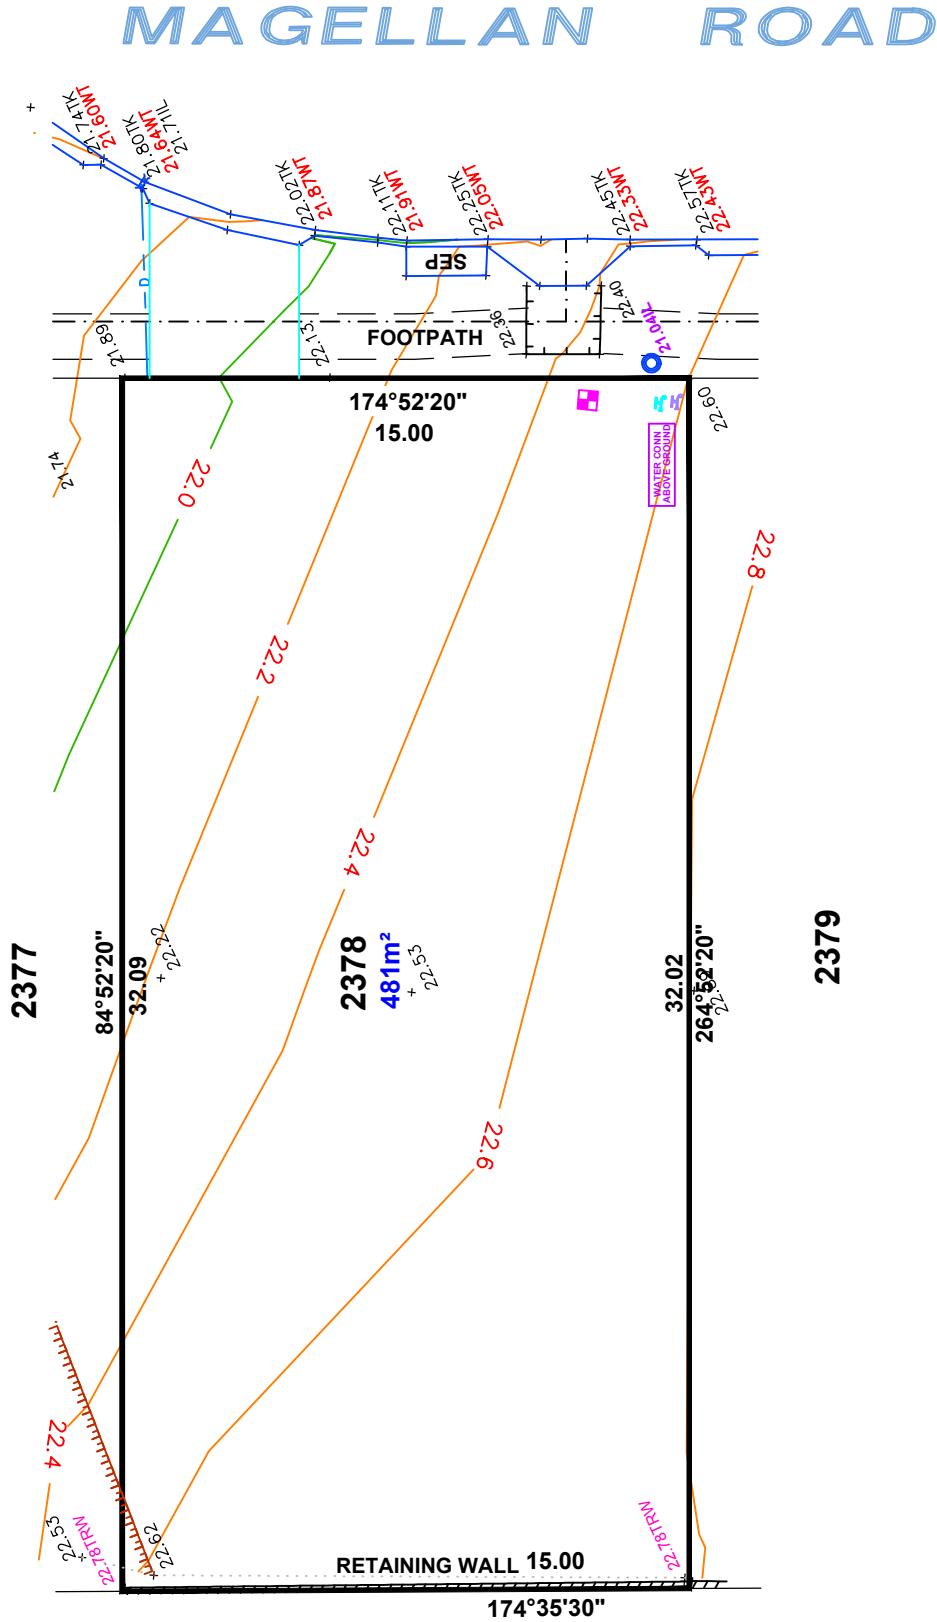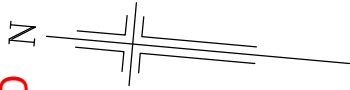

LEGEND

- WATER METER
- SEWER IP
- STOBIE POLE
- TELSTRA PIT
- SW GRATING
- SEWER MAN HOLE
- SW MANHOLE
- LIGHT POLE
- ETSA CONNECTION
- TAP
- BOLLARD
- SIGN
- SW CONNECTION
- FOOTPATH
- SIDE ENTRY PIT
- COMMON SERVICE TRENCH
- DOMESTIC
- SEWER IO
- NON-POTABLE WATER CONN
- NON-POTABLE WATER CONN
- TOP RETAINING WALL

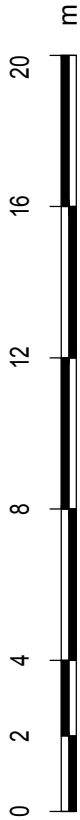

1:200

DISCLAIMER: FOOTPATH & CST DATA SHOWN HEREON IS DESIGN INFORMATION AND SHOULD BE CONFIRMED

ORIGINAL SHEET SIZE A4


NOTE:
DRIVEWAY IN PAVERS
BY DEVELOPER

IMPORTANT
SERVICE AND DRIVEWAY LOCATIONS
ARE SURVEYED. ANY CHANGES WILL
BE AT THE PURCHASERS EXPENSE.
PURCHASER: _____
PURCHASER: _____
DATE: _____


ALLOTMENT 2380 in DEV. NO. 145/D142/13/004
in the area named
SEAFORD MEADOWS

CT ---/---

AS CONSTRUCTED

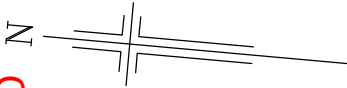

2379

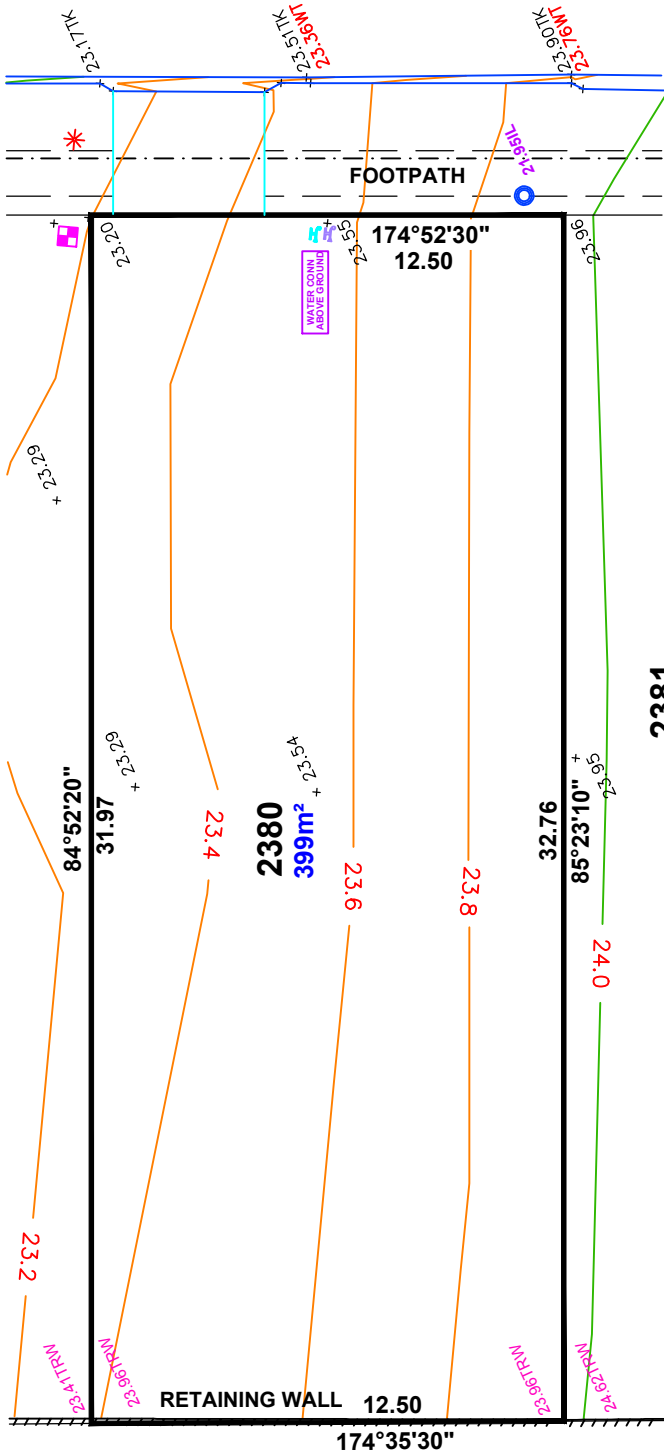

LEGEND

- WATER METER
- SEWER IP
- STOBIE POLE
- TELSTRA PIT
- SW GRATING
- SEWER MAN HOLE
- SW MANHOLE
- LIGHT POLE
- ETSA CONNECTION
- TAP
- BOLLARD
- SIGN
- SW CONNECTION
- FOOTPATH
- SIDE ENTRY PIT
- COMMON SERVICE TRENCH
- DOMESTIC
- SEWER IO
- NON-POTABLE WATER CONN
- NON-POTABLE WATER CONN
- TOP RETAINING WALL





1:200

DISCLAIMER: FOOTPATH & CST DATA SHOWN HEREON IS DESIGN INFORMATION AND SHOULD BE CONFIRMED

ORIGINAL SHEET SIZE A4

NOTE:
DRIVEWAY IN PAVERS
BY DEVELOPER

ALLOTMENT 2381 in DEV. NO. 145/D142/13/004
in the area named
SEAFORD MEADOWS
CT ---/----
AS CONSTRUCTED N

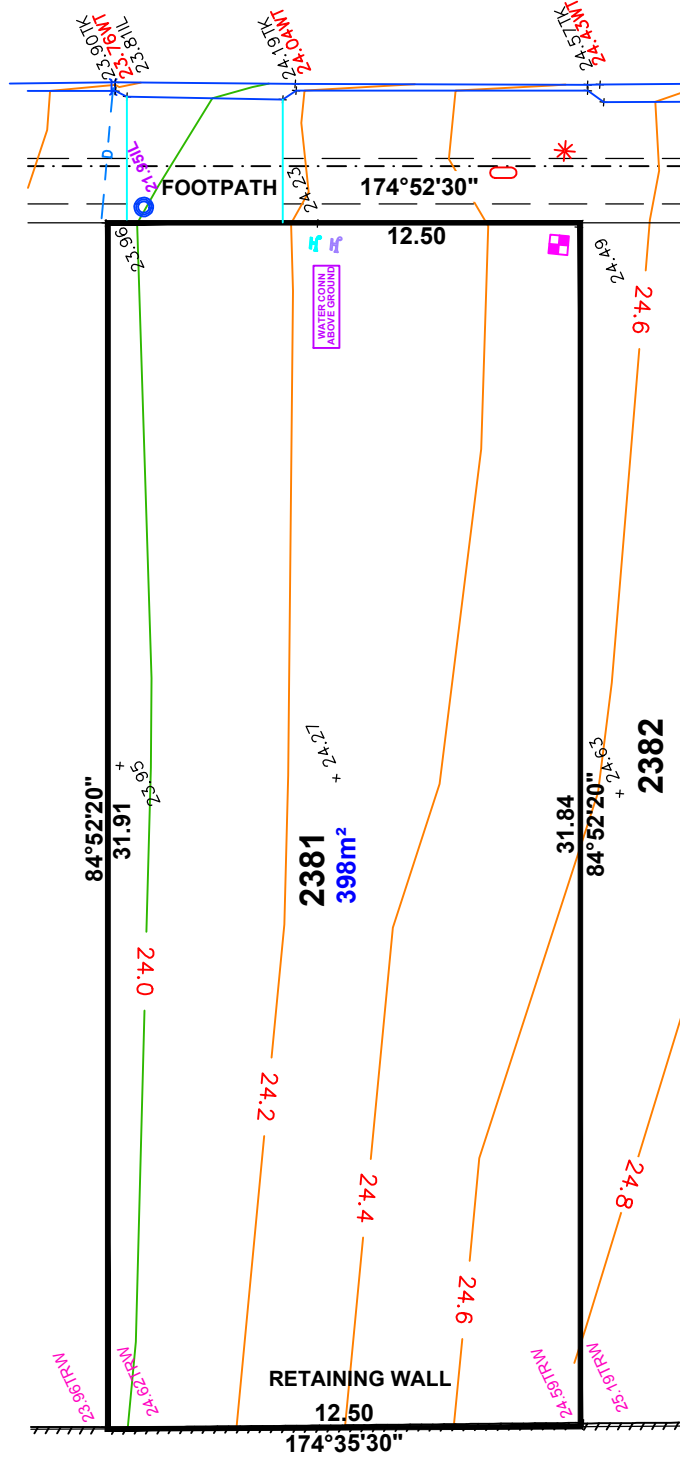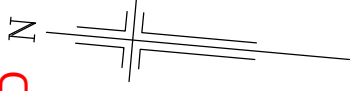

LEGEND

- | | |
|---|------------------------|
|  | WATER METER |
|  | SEWER IP |
|  | STOBIE POLE |
|  | TELSTRA PIT |
|  | SW GRATING |
|  | SEWER MAN HOLE |
|  | SW MANHOLE |
|  | LIGHT POLE |
|  | ETSA CONNECTION |
|  | TAP |
|  | BOLLARD |
|  | SIGN |
|  | SW CONNECTION |
|  | FOOTPATH |
|  | SIDE ENTRY PIT |
|  | COMMON SERVICE TRENCH |
|  | DOMESTIC |
|  | SEWER IO |
|  | NON-POTABLE WATER CONN |
|  | NON-POTABLE WATER CONN |
|  | TOP RETAINING WALL |

NOTE:
DRIVEWAY IN PAVERS
BY DEVELOPER



DISCLAIMER: FOOTPATH & CST DATA SHOWN HEREON IS DESIGN INFORMATION AND SHOULD BE CONFIRMED



ORIGINAL SHEET SIZE A4

IMPORTANT
SERVICE AND DRIVEWAY LOCATIONS
ARE SURVEYED. ANY CHANGES WILL
BE AT THE PURCHASERS EXPENSE.
PURCHASER: _____
PURCHASER: _____
DATE: _____

ALLOTMENT 2382 in DEV. NO. 145/D142/13/004
in the area named
SEAFORD MEADOWS

CT ---/---

AS CONSTRUCTED

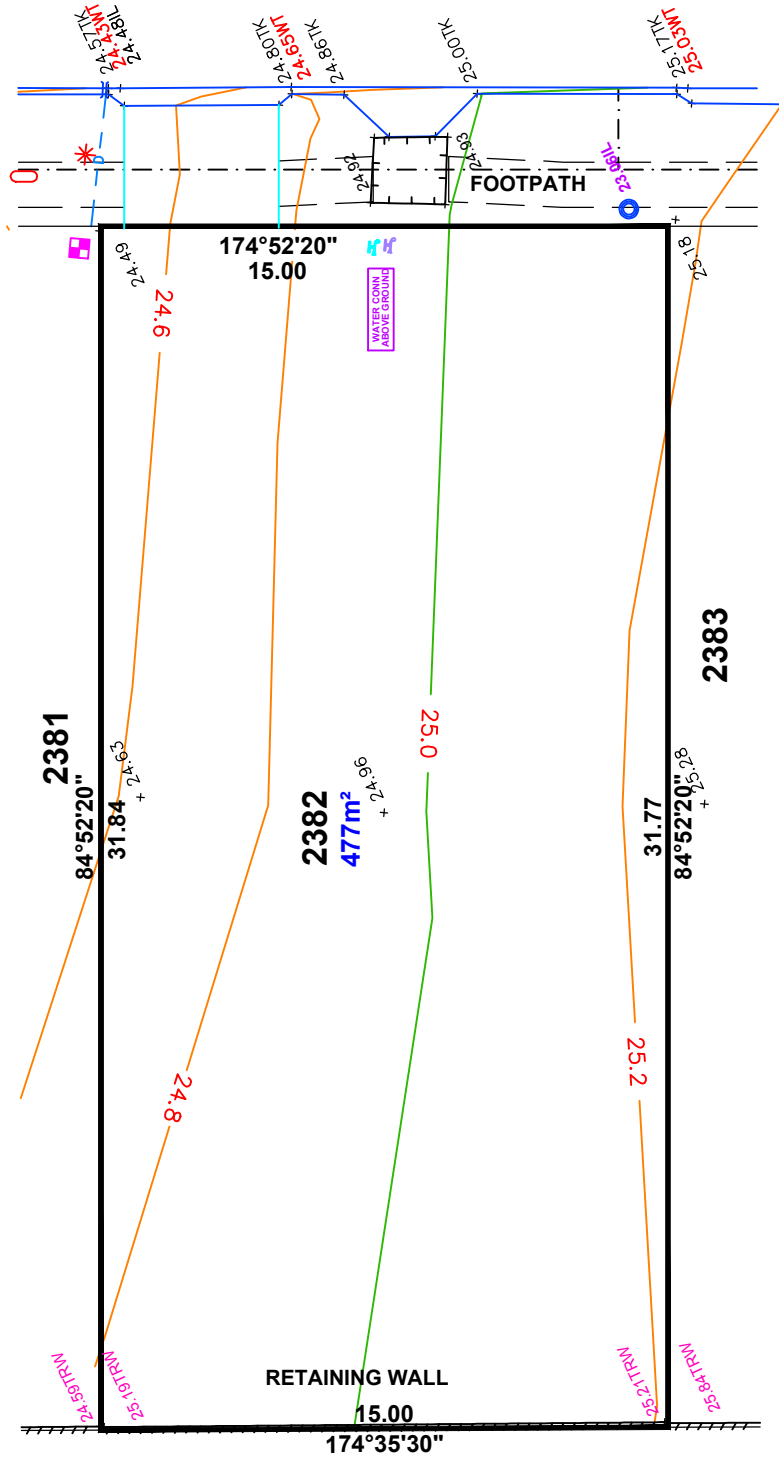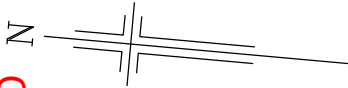

LEGEND

- WATER METER
- SEWER IP
- STOBIE POLE
- TELSTRA PIT
- SW GRATING
- SEWER MAN HOLE
- SW MANHOLE
- LIGHT POLE
- ETSA CONNECTION
- TAP
- BOLLARD
- SIGN
- SW CONNECTION
- FOOTPATH
- SIDE ENTRY PIT
- COMMON SERVICE TRENCH
- DOMESTIC
- SEWER IO
- NON-POTABLE WATER CONN
- NON-POTABLE WATER CONN
- TOP RETAINING WALL



1:200

DISCLAIMER: FOOTPATH & CST DATA SHOWN HEREON IS DESIGN INFORMATION AND SHOULD BE CONFIRMED

ORIGINAL SHEET SIZE A4

NOTE:
DRIVEWAY IN PAVERS
BY DEVELOPER